



THE CORPORATION OF THE CITY OF BRAMPTON

BY-LAW

Number 46-2003

To stop up and close part of
Adelaide Street

WHEREAS it is deemed expedient in the interest of The Corporation of the City of Brampton that Part of Adelaide Street as laid out on Plan TOR-11 described as Part 1 on Plan 43R-27861 be stopped up and closed;

AND WHEREAS notice of the intention to pass this by-law has been published at least five days prior to the Council meeting at which this By-law is being considered in the Brampton Guardian, a newspaper published in the City of Brampton, as per s.34(1) of the *Municipal Act, 2001* and City of Brampton By-law 393-2002;

AND WHEREAS the Council for the said Corporation has heard in person or by counsel, solicitor or agent, all persons claiming that their land will be prejudicially affected by this by-law and who applied to be heard;

NOW THEREFORE the Council of The Corporation of the City of Brampton **ENACTS AS FOLLOWS:**

1. The part of Adelaide Street as laid out on Plan TOR-11 described as Part 1 on Plan 43R-27861 is hereby stopped up and closed.

READ a FIRST, SECOND and THIRD TIME and PASSED in Open Council this 24th day of February, 2003.


Approved
as to Form
and Content
[Signature]
Feb 24/03

[Signature: Susan Fennell]
SUSAN FENNELL MAYOR

[Signature: Leonard J. Mikulich]
LEONARD J. MIKULICH CLERK

PLAN OF SURVEY OF
PART OF ADELAIDE STREET
PLAN TOR-11
 CITY OF BRAMPTON
 REGIONAL MUNICIPALITY OF PEEL

SCALE 1: 1000

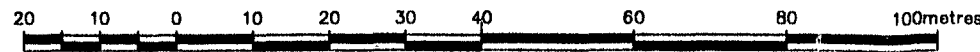


David B.Searles Surveying Ltd.

ONTARIO LAND SURVEYORS

METRIC

DISTANCES SHOWN ON THIS PLAN ARE IN METRES AND
 CAN BE CONVERTED TO FEET BY DIVIDING BY 0.3048

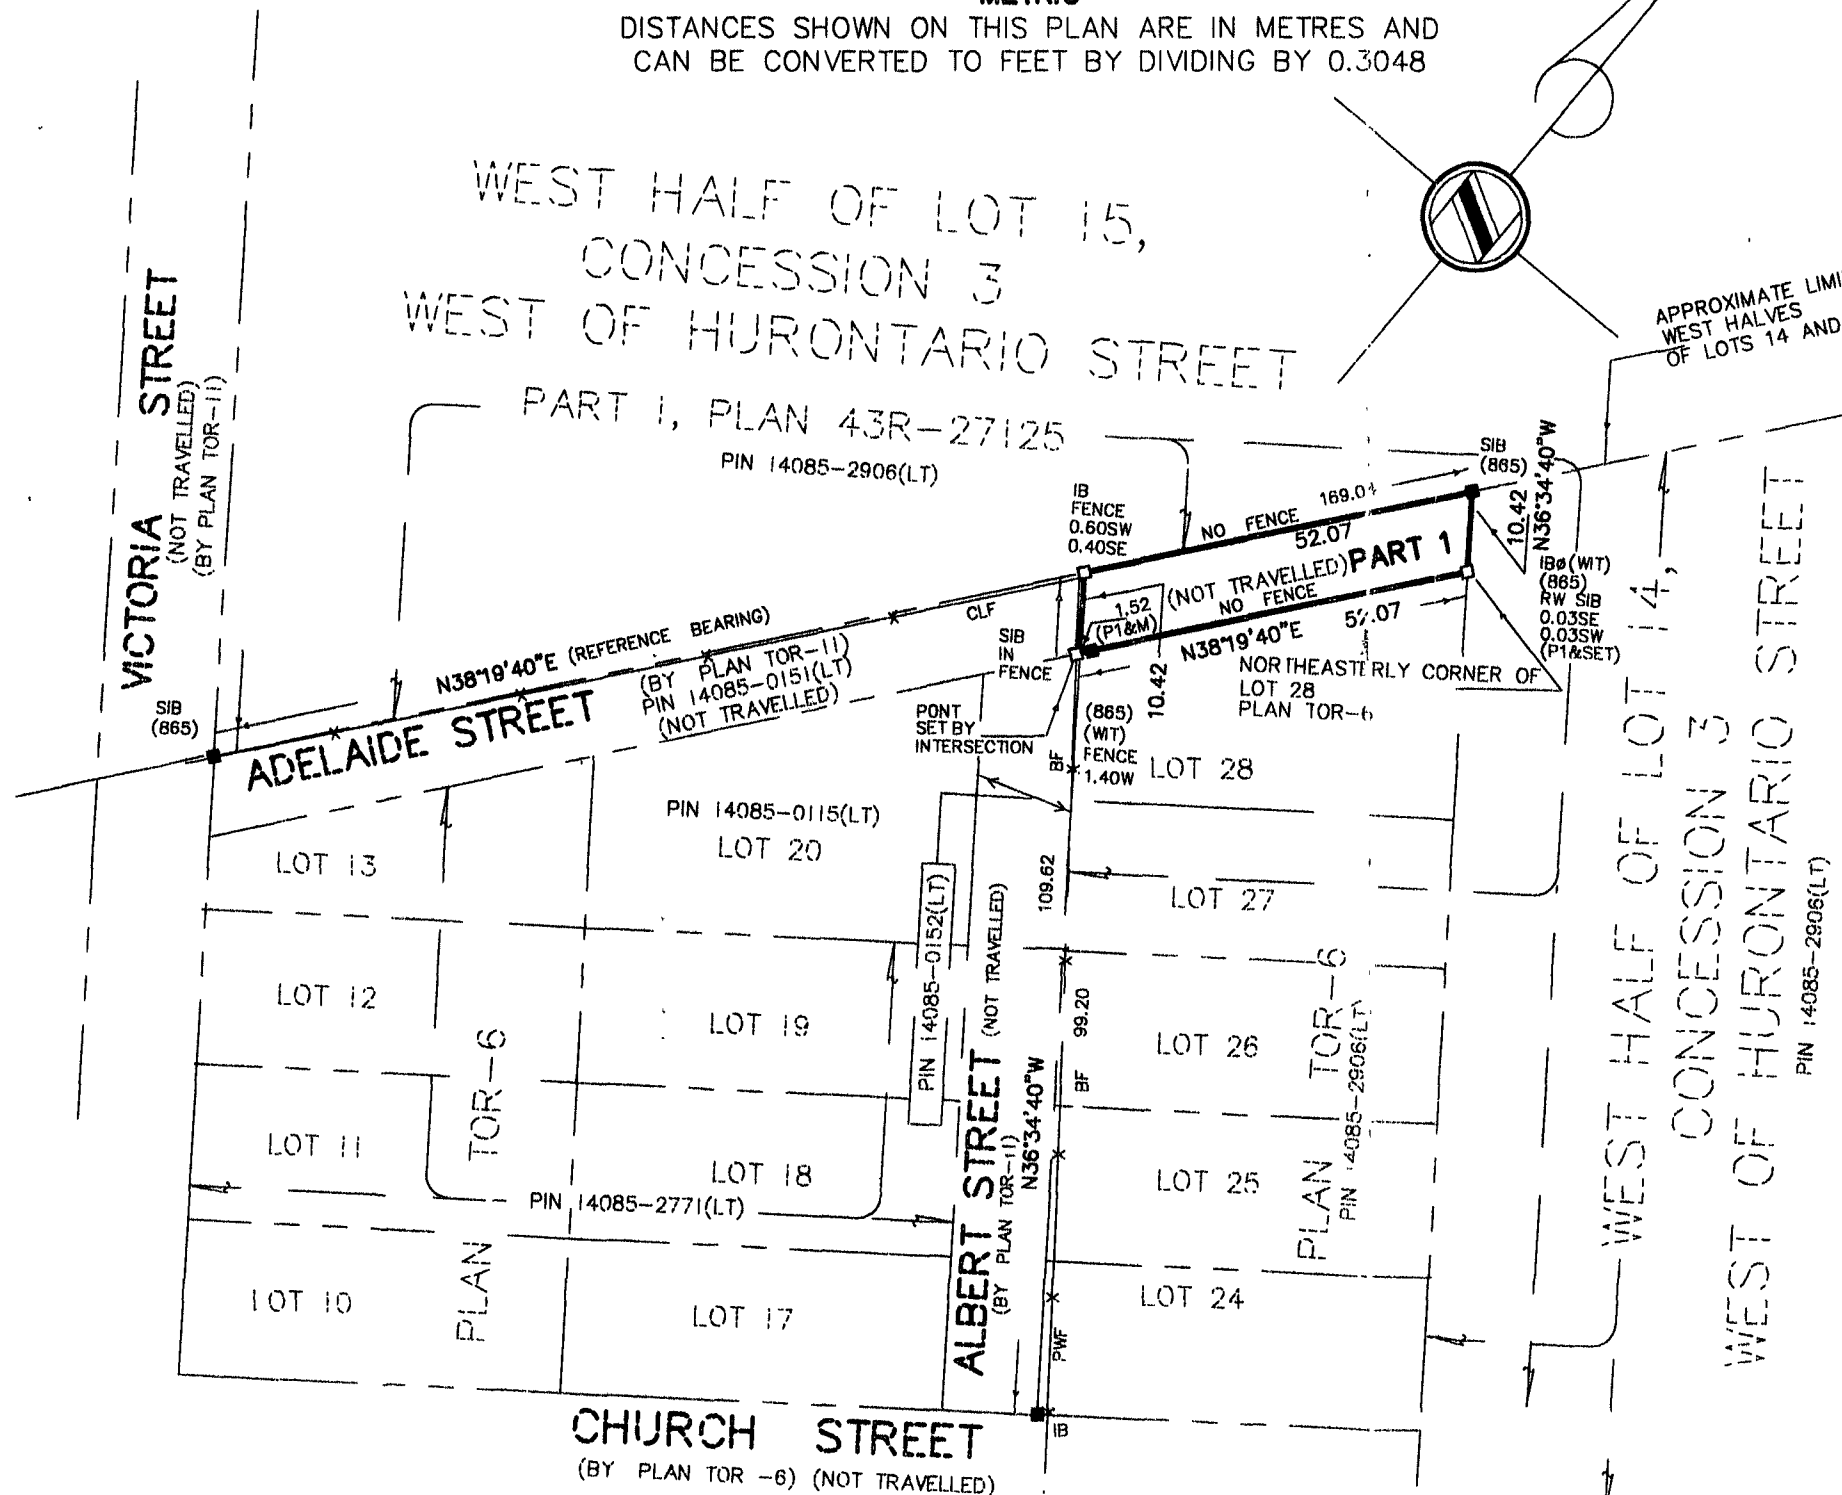

I require this plan to be deposited
 under the Land Titles Act

Date FEBRUARY 3, 2003

PLAN 43R-27861

Received and deposited

Date Feb. 5 2003

Alister Sankey

ALISTER SANKEY -O.L.S.

Carol Carrigan

ASSISTED
 LAND REGISTRAR
 FOR THE LAND TITLES DIVISION OF
 PEEL (No. 43)

SCHEDULE

PART	LOT	PLAN	PIN
1	PART OF ADELAIDE STREET	TOR 11	PART OF PIN 14085-0151(LT)

NOTE

BEARINGS ARE ASTRONOMIC AND ARE REFERRED TO THE NORTHWESTERLY LIMIT OF
 OF ADELAIDE STREET PLAN TOR-11 AS SHOWN ON PLAN 43R-27125,
 HAVING A BEARING OF N38°19'40"E.

LEGEND

- DENOTES MONUMENT FOUND
- DENOTES MONUMENT SET
- SIB DENOTES STANDARD IRON BAR
- IB DENOTES IRON BAR
- WT DENOTES WITNESS
- 865 DENOTES D. McLEAN O.L.S.
- BF DENOTES BOARD FENCE
- CLF DENOTES CHAIN-LINK FENCE
- ⊙ DENOTES ROUND
- P1 DENOTES PLAN 43R-27125
- RW DENOTES REPLACED WITH

SURVEYOR'S CERTIFICATE

I CERTIFY THAT :

- THIS SURVEY AND PLAN ARE CORRECT AND IN ACCORDANCE WITH THE SURVEYS ACT, THE SURVEYORS ACT, AND THE LAND TITLES ACT AND THE REGULATIONS MADE UNDER THEM.
- THE SURVEY WAS COMPLETED ON THE 27th DAY OF JANUARY, 2003

FEBRUARY 3, 2003

DATE

Alister Sankey

ALISTER SANKEY -ONTARIO LAND SURVEYOR

David B.Searles Surveying Ltd.

ONTARIO LAND SURVEYORS
 4284 VILLAGE CENTRE COURT, MISSISSAUGA, ONTARIO L4Z 1S2
 (905) 273-6840 FAX: (905) 896-4410
 E MAIL: DBSOLS @ ON.AIBN.COM

Drawn K.P. Checked A.D.S.

File No. **135-7-01**

Computer Storage File No.
 134-135PN.FLX

Operator
 A.D.S.

Disk Plan Storage No.
 135-7-01.DWG

Plan Index No.
 J 9

43R-27861